

Work Order ID 94309

December-06-12 11:48:22 AM

94309

Page 1

Item ID: D3177-041 Accept ***N900040100*** Setup Start ***NS1***
 Revision ID: Stop ***NS2***
 Item Name: Bracket
 Start Date: 12/06/12 Start Qty: 2.00 ***2*** Cust Item ID:
 Required Date: 12/13/12 Req'd Qty: 2.00 ***2*** Customer:

Reference:

Approvals: Process Plan: W Date: Tooling: Date: Run Start ***NR1***
 QC: Date: SPC (Y/N): Date: Stop ***NR2***

| Sequence ID/ Work Center ID | Operation Description | Set Up/ Run Hours | Tool ID | Tool # | Plan Code | Accept Qty | Reject Qty | Reject Number | Insp. Stamp |
|--------------------------------|---|----------------------|---------|-------------|--------------|---------------|---------------|------------------|----------------|
| Draw Nbr | Revision Nbr | | | | | | | | |
| D3177 | Rev B2 | | | | | | | | |
| 100 | | 0.00 | | | | | | | |
| *100* | BAND SAW | | | | | | | | |
| Bandsaw | Memo | 0.00 | | | | | | | |
| Jaspa Bandsaw | Cut blank: 47.40" x (12.000" +0.100/-0.000) | | | 12-12-10 | | | | | |
| 110 | | 0.00 | | | | | | | |
| *110* | HAAS CNC VERTICAL MACHINING #1 | | | | | | | | |
| HAAS 1 | Memo | 0.00 | | PO 12-12-16 | | 2 | 0 | | |
| HAAS CNC vertical machine #1 | 1-Machine part as per Folio FA291 and Dwg D31772-Deburr | | | | | | | | |
| 120 | | 0.00 | | | | | | | |
| *120* | QC2- Inspect parts off machine FAI/FAIB | | | | | | | | |
| QC | Memo | 0.00 | | PO 12-12-17 | | 2 | 0 | | |
| Quality Control | | | | | | | | | |

(Handwritten signature/initials)

Work Order ID 94309

94309

Page 2

December-06-12 11:48:22 AM

Item ID: D3177-041 Accept ***N900040100*** Setup Start ***NS1***
 Revision ID: Stop ***NS2***
 Item Name: Bracket
 Start Date: 12/06/12 Start Qty: 2.00 ***2*** Cust Item ID:
 Required Date: 12/13/12 Req'd Qty: 2.00 ***2*** Customer:
 Reference:

Approvals: Process Plan: _____ Date: _____ Tooling: _____ Date: _____ Run Start ***NR1***
 QC: _____ Date: _____ SPC (Y/N): _____ Date: _____ Stop ***NR2***

| Sequence ID/ Work Center ID | Operation Description | Set Up/ Run Hours | Tool ID | Tool # | Plan Code | Accept Qty | Reject Qty | Reject Number | Insp. Stamp |
|---|--|----------------------|---------|----------|--------------|---------------|---------------|------------------|----------------|
| 130 *130* QC Quality Control | QC8- Inspect parts - second check Memo | 0.00 0.00 | | 12/12/21 | | 2 | 0 | | DAS 08 |
| 140 *140* HandFinish Hand Finishing | Chemical Conversion Coat per QS1005 4.1 Memo | 0.00 0.00 | | | | 2 | | RB 2-1-13 | |
| 150 *150* Small Fab Small Fab | Small Fab Memo 1-Press D3177-5 Spacers as shown on Dwg D3177 | 0.00 0.00 | | | | 2x | | | ES 13/01/10 |

Work Order ID 94309

December-06-12 11:48:22 AM

94309

Page 3

Item ID: D3177-041 Accept *N900040100* Setup Start *NS1*
 Revision ID: Stop *NS2*
 Item Name: Bracket
 Start Date: 12/06/12 Start Qty: 2.00 *2* Cust Item ID:
 Required Date: 12/13/12 Req'd Qty: 2.00 *2* Customer:
 Reference:

Approvals: Process Plan: Date: Tooling: Date: Run Start *NR1*
 QC: Date: SPC (Y/N): Date: Stop *NR2*

| Sequence ID/ Work Center ID | Operation Description | Set Up/ Run Hours | Tool ID | Tool # | Plan Code | Accept Qty | Reject Qty | Reject Number | Insp. Stamp |
|---|--|----------------------|---------|--------|--------------|---------------|---------------|------------------|----------------|
| 160 *160* Powdercoat Powder Coating | White Gloss(Ref.4.3.5.1)per QSI005 4.3-Alum M123383 Memo START TIME: 1:05 OVEN TEMPERATURE: 3:00 FINISH TIME: 1:35 | 0.00 0.00 | | | | 2 | 0 | 13-1-14 | |
| 170 *170* QC Quality Control | QC3- Inspect Part Finish Memo | 0.00 0.00 | | | | 2x | | 13/01/15 | |
| 180 *180* Small Fab Small Fab Small Fab | Small Fab Memo Assemble as per Dwg D3177 | 0.00 0.00 | | | | 2x | | 13/01/15 | |

94309

December-06-12 11:48:22 AM

N900040100

Setup Start *NS1*

Stop *NS2*

Start Date: 12/06/12 **Start Qty:** 2.00 ***2***

Cust Item ID:

Required Date: 12/13/12 **Req'd Qty:** 2.00 ***~***

Customer:

Reference:

Run Start *NR1*

Approvals: **Process Plan:** **Date:** _____ **Tooling:** _____ **Date:** _____

Stop *NR2*

QC: _____ Date: _____ SPC (Y/N): _____ Date: _____

**Insp.
Stamp**

190

QC5- Inspect part completeness to step on W/O

0.00

190

QC

Memo

0.00

Quality Control

AS
15
89
13.1.15

200

Identify as per dwg & Stock Location: ST/66 0.00

0.00

200

Packaging

Memo

0.00

Packaging

2x _____ SP
13-01-18

210

QC21- Final Inspection - Work Order Release

0.00

210

OC

Memo

0.00

Quality Control

13/1/14 ~~JD~~

1013-01-15

Picklist Print

December-06-12 11:48:21 AM

Page 1

Work Order ID: 94309

Parent Item: D3177-041

Parent Item Name: Bracket

Start Date: 12/06/12

Required Date: 12/13/12

Start Qty: 2.00

Required Qty: 2.00

Comments: IPP Rev:B03.01.27Added Step 12KJ/RF

| Component Item ID/ Item Name | Replacement Item ID | Mfg/ Purch | Bin Item | Primary Location | Last Location | Route Seq ID | Unit of Measure | Qty on Hand | Qty per Kit | Total Qty | Qty Issued | Date Issued | Status |
|---------------------------------|------------------------|---------------|-------------|---------------------|------------------|-----------------|--------------------|----------------|-------------|--------------|---------------|----------------|--------|
| AN960JD10 Washer | NAS1149D0363J | Purchased | No | | | 180 | Each | 0.0000 | 3 | | | | |
| BLRS-010 Pip Pin | | Purchased | No | | | 180 | Each | 36.0000 | 1 | | | | |

Location

Loc Qty

Loc Code

| | | |
|--------|----|--|
| FG | 4 | |
| 121374 | 4 | |
| ST283 | 32 | |
| 118207 | 1 | |
| 120178 | 2 | |
| 122730 | 29 | |

D2690-6
Lanyard Assembly

Manufactured No

180 Each 30.0000

1 2

Location

Loc Qty

Loc Code

| | | |
|-------|----|--|
| GA | 3 | |
| 91957 | 3 | |
| ST014 | 27 | |
| 90568 | 2 | |
| 91642 | 1 | |
| 92559 | 4 | |
| 92739 | 6 | |
| 92867 | 4 | |
| 93401 | 10 | |

D2690-6RevB2
Lanyard Assembly

Manufactured No

180 Each 0.0000

1 2

D3177-5
Spacer

Manufactured No

180 Each 13.0000

4 8

Location

Loc Qty

Loc Code

| | | |
|-------|----|--|
| ST032 | 13 | |
| 20295 | 13 | |

B95228 (3x)

Picklist Print

December-06-12 11:48:21 AM

Page 2

Work Order ID: 94309

Parent Item: D3177-041

Parent Item Name: Bracket

Start Date: 12/06/12

Required Date: 12/13/12

Start Qty: 2.00

Required Qty: 2.00

~~MS21042L3~~ 12.000/ 12/12/10

Spacer

M6061T6B1.000X13.000

6061T6 BAR 1.00 X 13.00

MS21042L3

Nut

Manufactured No

Purchased No

Purchased No

180 Each 0.0000

f 0.0000

180 Each 4,811.0000

3.96 4

1 2

Location

Loc Qty

Loc Code

FP001

141

122141

141

GA

419

122452

419

ST300

225

117885

32

119017

55

119075

138

ST314

526

123265

526

ST506

3500

123900

3500

MS27039-1-11

Purchased No

100 Each 137.0000

Screw

Location

Loc Qty

Loc Code

GA

37

9662

37

ST305

100

123352

100

12-12-10
13/01/10

2
13/01/15

2

December-06-12 11:48:21 AM

Shop Packet Print


Page 2


| | | |
|----------------------------------|----------------|-----------------------------|
| D3065-5DART AEROSPACE LTD | | Work Order: 94309 |
| Description: Bracket | | Part Number: D3177-1 |
| Inspection Dwg: D3177 | Rev: B2 | Page 1 of 1 |

FIRST ARTICLE INSPECTION CHECKLIST

☒ First Article ☐ Prototype

| Drawing Dimension | Tolerance | Actual Dimension | Accept | Reject | Method of Inspection | Comments |
|-------------------|---------------|------------------|--------|--------|----------------------|----------|
| 0.970 | +0.010/-0.000 | .973 | ✓ | | Mic | 118-120 |
| R0.125 | +/-0.010 | .125 | ✓ | | Rad gage | |
| 0.700 | +0.010/-0.000 | .694 | | | Mic | PHD-02 |
| 0.188 | +0.010/-0.000 | .193 | ✓ | | Mic | 118-120 |
| 0.300 | +/-0.010 | .295 | ✓ | | VERN | PHD-01 |
| 10.776 | +/-0.005 | 10.773 | ✓ | | VERN | CNC-02 |
| R0.625 | +/-0.010 | .625 | ✓ | | Rad gage | |
| Ø0.261 | +0.005/-0.000 | .267 | ✓ | | VERN | PHD-01 |
| 0.200 | +/-0.010 | .182 | | | " | " |
| 0.970 | +0.010/-0.000 | .973 | ✓ | | Mic | 118-120 |
| Ø0.203 | +/-0.005 | .205 | ✓ | | VERN | PHD-01 |
| Ø0.625 | +0.001/-0.000 | .626 | ✓ | | Mic | PHD-02 |
| 3.733 | +0.000/-0.005 | 3.733 | ✓ | | VERN | PHD-01 |
| 0.970 | +0.010/-0.000 | .973 | ✓ | | " | " |
| 0.700 | +0.010/-0.000 | .694 | | | Mic | PHD-02 |
| | | | | | | |
| | | | | | | |
| | | | |
|------------------------|---|----------------------------|-----|
| Measured by: PO | Audited by: JA  | Prototype Approval: | N/A |
| Date: 12-12-17 | Date: 12/12/21 | Date: | N/A |
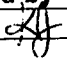
| Rev | Date | Change | Revised by | Approved |
|-----|----------|-----------|-----------------------------|---|
| A | 04.02.25 | New Issue | P/O D3177-041/-043 KJ/RF |  |

2.5606


DART



DART AEROSPACE LTD
HAWKESBURY, ONTARIO, CANADA

| DESIGN | DRAWN BY | DART AEROSPACE LTD |
|----------|----------|--------------------|
| CHECKED | APPROVED | DRAWING NO. |
| DATE | | TITLE |
| 03.01.07 | 02.12.03 | BRACKET |
| A | 03.01.07 | NEW ISSUE |
| B | | RE-DESIGN |
| | | SCALE |
| | | 1:5 |
| | | SHEET 1 OF 3 |
| | | REV. B |

| | | | |
|----|----------|------|---------------|
| B1 | 03.02.25 | CP-# | ADD SPOT FACE |
| B2 | 03.11.24 | CP-# | ADD D3177-7 |

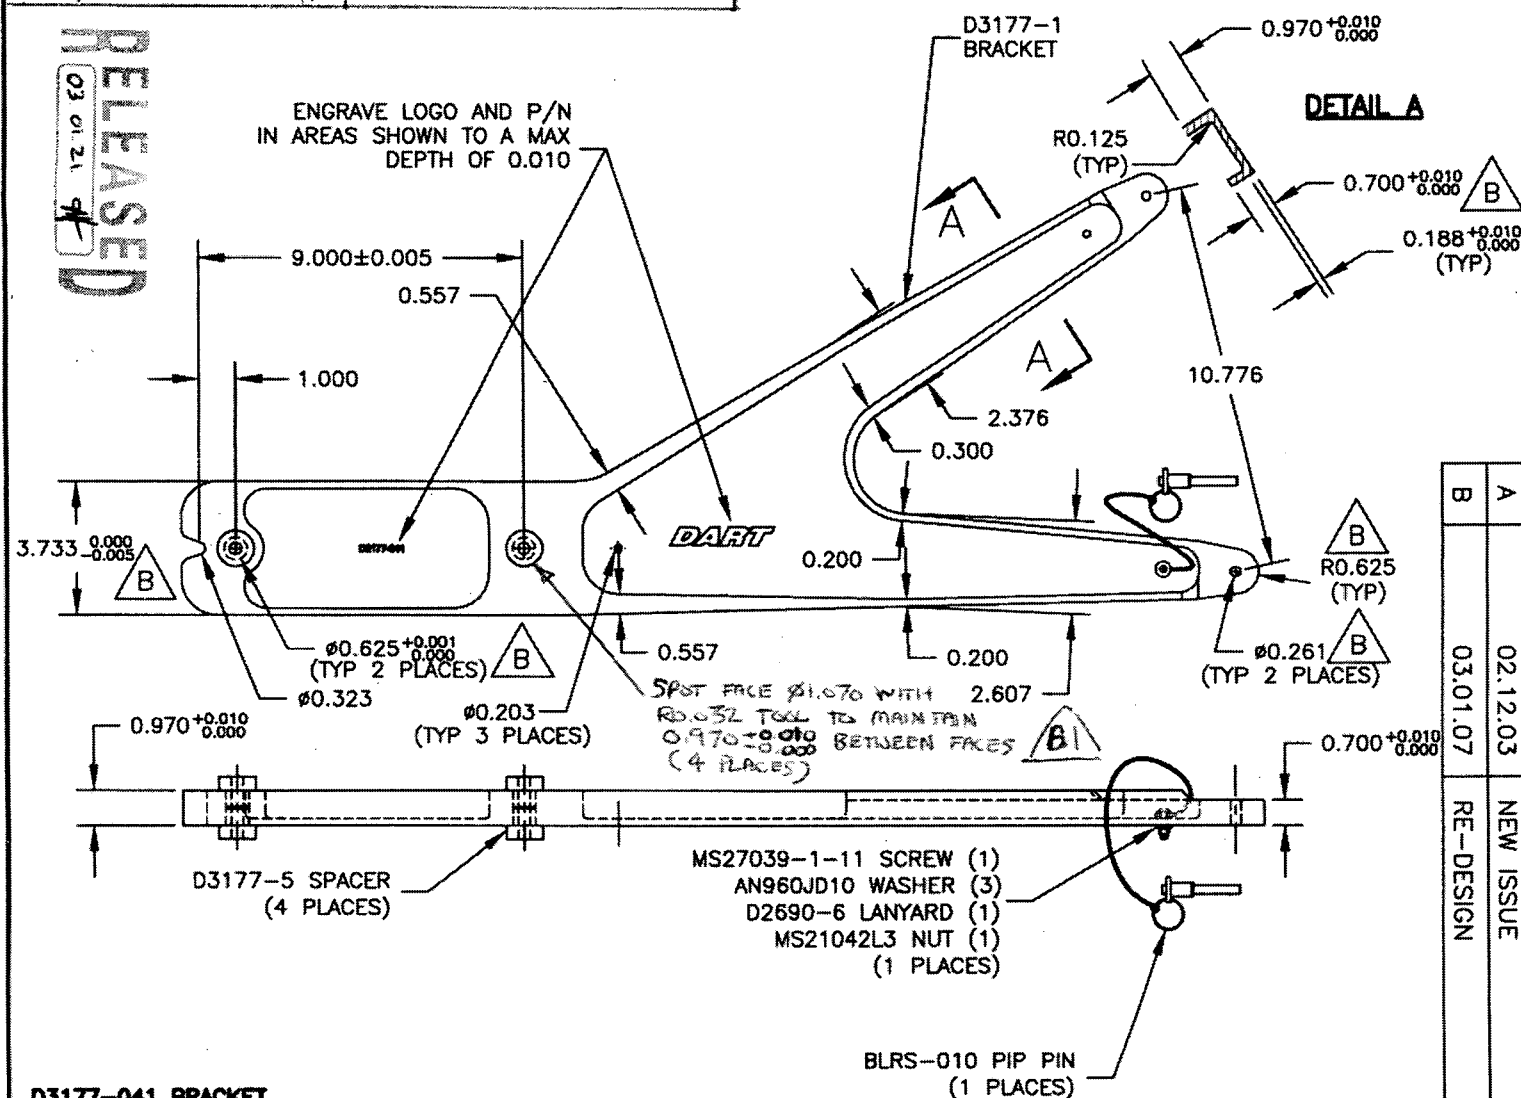

D3177-041 BRACKET

- 1) MACHINE D3177-1 PER DART DWG "D3177-1.SLDPRT"
MATERIAL: 6061-T6 ALUMINUM BAR (QQ-A-250/11 OR QQ-A-200/8)
(REF DART SPEC. M6061T6S OR M6061T6B)
- 2) BREAK ALL SHARP EDGES 0.005 TO 0.015
- 3) FINISH: CHEMICAL CONVERSION COAT PER DART QSI 005 4.1 (PRIOR TO ASSEMBLY)
POWDER COAT WHITE (4.3.5.1) PER DART QSI 005 4.3 (AFTER ASSEMBLY)
- 4) TOLERANCES ARE PER QSI 018 UNLESS OTHERWISE NOTED
- 5) ALL DIMENSIONS ARE IN INCHES

94309

THIS DOCUMENT IS PRIVATE AND CONFIDENTIAL, AND IS SUPPLIED ON THE EXPRESS CONDITION THAT IT IS NOT TO BE USED FOR ANY PURPOSE OR COPIED OR COMMUNICATED TO ANY OTHER PERSON WITHOUT WRITTEN PERMISSION FROM DART AEROSPACE LTD.


Copyright © 2002 by DART AEROSPACE LTD

RELEASED
03.01.21

DART



| | | | |
|---------|----------|--------------|-----------------------------|
| DESIGN | APPROVED | DRAWN BY | DART AEROSPACE LTD |
| CHECKED | APPROVED | DRAWING NO. | HAWKESBURY, ONTARIO, CANADA |
| DATE | 03.01.07 | TITLE | BRACKET |
| | | SCALE | 1:5 |
| | | SHEET 2 OF 3 | |
| | | REV. B | |

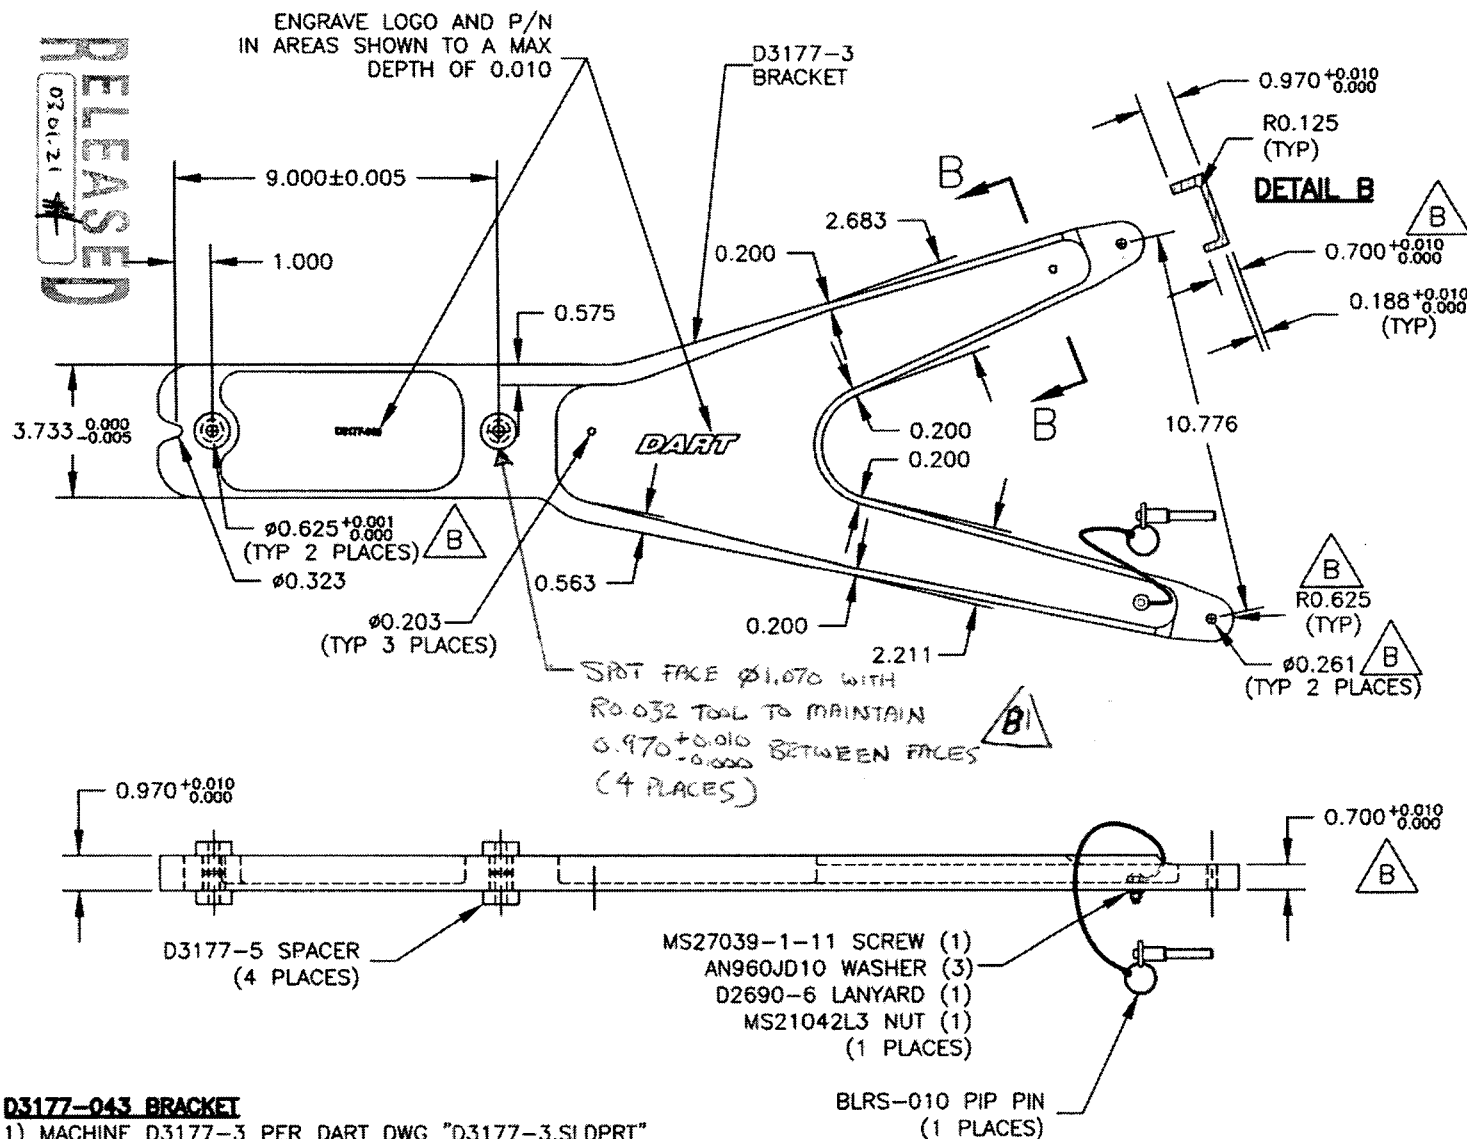


D3177-043 BRACKET

- 1) MACHINE D3177-3 PER DART DWG "D3177-3.SLDPR" MATERIAL: 6061-T6 ALUMINUM BAR (QQ-A-250/11 OR QQ-A-200/8) (REF DART SPEC. M6061T6S OR M6061T6B)
- 2) BREAK ALL SHARP EDGES 0.005 TO 0.015
- 3) FINISH: CHEMICAL CONVERSION COAT PER DART QSI 005 4.1 (PRIOR TO ASSEMBLY) POWDER COAT WHITE (4.3.5.1) PER DART QSI 005 4.3 (AFTER ASSEMBLY)
- 4) TOLERANCES ARE PER QSI 018 UNLESS OTHERWISE NOTED
- 5) ALL DIMENSIONS ARE IN INCHES

RELEASED
03.01.21



| | | | |
|-------------------------------|--------------------------------|---|------------------------|
| DESIGN <i>UP</i> | DRAWN BY <i>UP</i> | DART AEROSPACE LTD HAWKESBURY, ONTARIO, CANADA | |
| CHECKED <i>[Signature]</i> | APPROVED <i>[Signature]</i> | DRAWING NO. D3177 | REV. B SHEET 3 OF 3 |
| DATE 03.01.07 | | TITLE BRACKET | SCALE 1:1 |

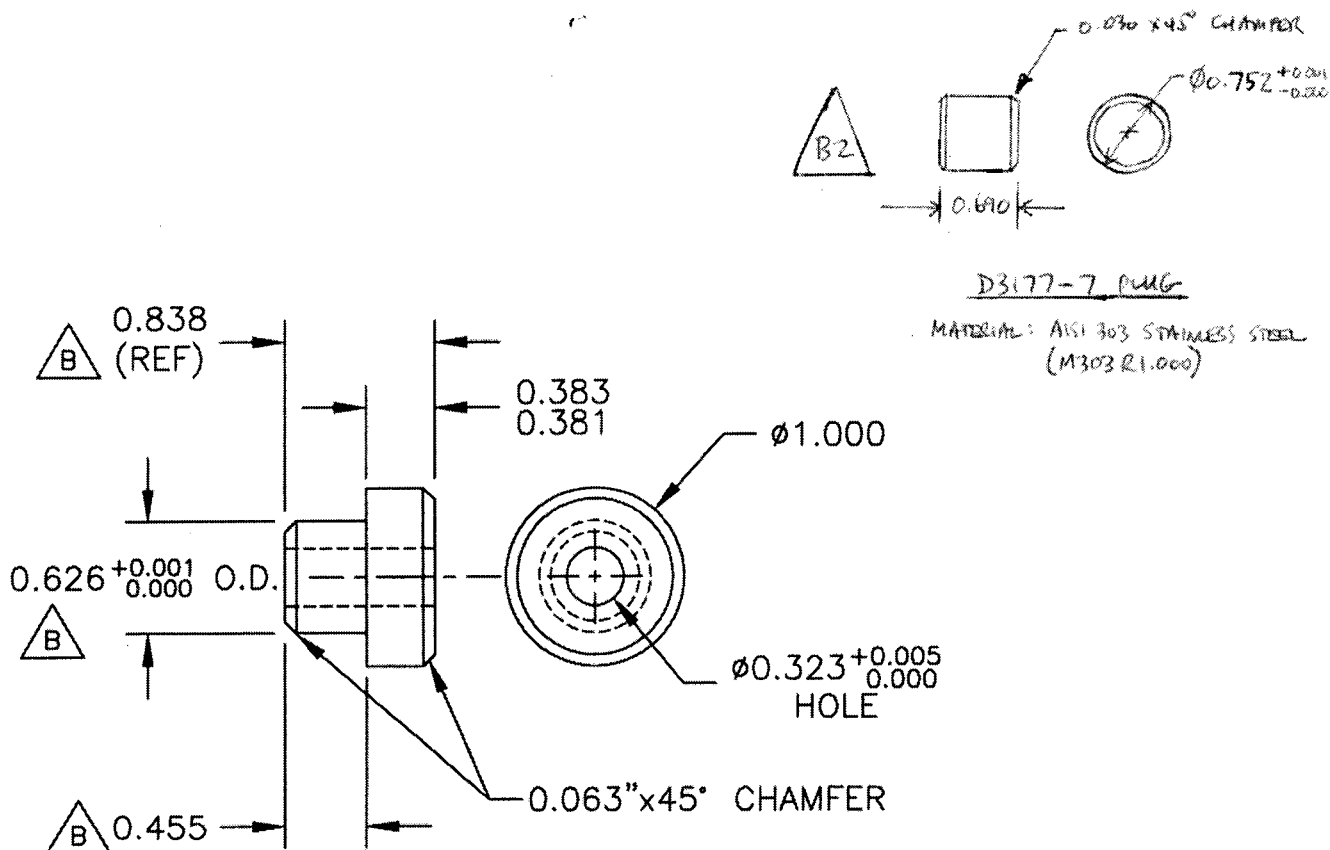

D3177-5

- 1) MATERIAL: 6061-T6 ALUMINUM BAR $\phi 1.000$
(QQ-A-200/8 OR QQ-A-225/8)
(REF DART SPEC. M6061T6R1.000)
- 2) BREAK ALL SHARP EDGES 0.005 TO 0.010
- 3) FINISH: CHEMICAL CONVERSION COAT PER DART QSI 005 4.1
- 4) TOLERANCES ARE PER DART QSI 018 UNLESS OTHERWISE NOTED
- 5) ALL DIMENSIONS ARE IN INCHES

RELEASED
03 01-21 *[Signature]*

Copyright © 2002 by DART AEROSPACE LTD

THIS DOCUMENT IS PRIVATE AND CONFIDENTIAL AND IS SUPPLIED ON THE EXPRESS CONDITION THAT IT IS NOT TO BE USED FOR ANY PURPOSE OR COPIED OR COMMUNICATED TO ANY OTHER PERSON WITHOUT WRITTEN PERMISSION FROM DART AEROSPACE LTD.

NCR: Yes / No

WORK ORDER NON-CONFORMANCE / UPDATE

DQA: _____ Date: _____

QA Closed: _____ Date: _____

| | | | | | | | | | | | | | | | | | | |
|---|--|---|--------------------------------------|------------------------------------|------------------------------------|--------------------------------------|---|------------------------------------|--|----------------------------------|--|------------------------------------|--|--------------------------------|------------------------------------|------------------------------------|-----------------------------------|--|
| Work Order: <u>94309</u> Part No. _____ NCR No. _____ | DISPOSITION Rework <input type="checkbox"/> Scrap <input type="checkbox"/> Use-as-is <input checked="" type="checkbox"/> Work Order Update <input type="checkbox"/> | AGAINST DEPARTMENT/PROCESS <table style="width:100%; font-size: small;"> <tr> <td>Skid-tube <input type="checkbox"/></td> <td>Crosstube <input type="checkbox"/></td> <td>Water Jet <input type="checkbox"/></td> <td>Engineering <input type="checkbox"/></td> </tr> <tr> <td>Machining <input checked="" type="checkbox"/></td> <td>Small Fab <input type="checkbox"/></td> <td>Prod. Eng. Coord. <input type="checkbox"/></td> <td>Quality <input type="checkbox"/></td> </tr> <tr> <td>Thermoforming <input type="checkbox"/></td> <td>Finishing <input type="checkbox"/></td> <td>Rec/Store/Packaging <input type="checkbox"/></td> <td>Other <input type="checkbox"/></td> </tr> <tr> <td>Large Fab <input type="checkbox"/></td> <td>Composite <input type="checkbox"/></td> <td>Supplier <input type="checkbox"/></td> <td></td> </tr> </table> | Skid-tube <input type="checkbox"/> | Crosstube <input type="checkbox"/> | Water Jet <input type="checkbox"/> | Engineering <input type="checkbox"/> | Machining <input checked="" type="checkbox"/> | Small Fab <input type="checkbox"/> | Prod. Eng. Coord. <input type="checkbox"/> | Quality <input type="checkbox"/> | Thermoforming <input type="checkbox"/> | Finishing <input type="checkbox"/> | Rec/Store/Packaging <input type="checkbox"/> | Other <input type="checkbox"/> | Large Fab <input type="checkbox"/> | Composite <input type="checkbox"/> | Supplier <input type="checkbox"/> | |
| Skid-tube <input type="checkbox"/> | Crosstube <input type="checkbox"/> | Water Jet <input type="checkbox"/> | Engineering <input type="checkbox"/> | | | | | | | | | | | | | | | |
| Machining <input checked="" type="checkbox"/> | Small Fab <input type="checkbox"/> | Prod. Eng. Coord. <input type="checkbox"/> | Quality <input type="checkbox"/> | | | | | | | | | | | | | | | |
| Thermoforming <input type="checkbox"/> | Finishing <input type="checkbox"/> | Rec/Store/Packaging <input type="checkbox"/> | Other <input type="checkbox"/> | | | | | | | | | | | | | | | |
| Large Fab <input type="checkbox"/> | Composite <input type="checkbox"/> | Supplier <input type="checkbox"/> | | | | | | | | | | | | | | | | |


| Root Cause | Date | Step | Qty | Description of work order update or Non-conformance | Initial Chief Eng | Action Description | Sign & Date | Verification | QC Inspector |
|--|----------|------|-----|---|-------------------------------|--|-------------------------------|--------------|--------------|
| Doc/Data <input type="checkbox"/> | 12-12-17 | 110 | 1 | The Two Leg STEP DIM of .700 is under tolerance of .006. Reason: Wrong tool was used Qty 1 | DAS 12 2-83 12/12/17 | Acceptable. Margins of safety are still positive per SR-D130-701-1 Rev A | PD 12-12-17 | | |
| Equip/Tooling <input type="checkbox"/> | | | 2 | The Thickness of the Wall on one leg of .200 is .192 due to imperfection in Blank Material Qty 2 Parts | DAS 12 2-83 12/12/17 | Acceptable. Moment of inertia of section is larger than that analyzed in SR-D130-701-1 Rev A | DAS 12 2-83 12/12/17 | 12/12/17 | 12/12/17 |
| Operator <input checked="" type="checkbox"/> | | | | | | | | | |
| Material <input checked="" type="checkbox"/> | | | | | | | | | |
| Setup <input type="checkbox"/> | | | | | | | | | |
| Other <input type="checkbox"/> | | | | | | | | | |
| Process <input type="checkbox"/> | | | | | | | | | |
| Supplier <input type="checkbox"/> | | | | | | | | | |
| Training <input type="checkbox"/> | | | | | | | | | |
| Unapproved <input type="checkbox"/> | | | | | | | | | |

FAULT CATEGORY

| Landing Gear | General | Other |
|---|---|--|
| <input type="checkbox"/> Bending | <input type="checkbox"/> Bend | <input type="checkbox"/> Grain |
| <input type="checkbox"/> Centre Not Concentric to O/S | <input type="checkbox"/> BOM/Route | <input type="checkbox"/> Hardware |
| <input type="checkbox"/> Cracks | <input type="checkbox"/> Broken/Damaged | <input type="checkbox"/> Inspection Incomplete |
| <input type="checkbox"/> Crushed/Crimped | <input type="checkbox"/> Burrs | <input type="checkbox"/> Instructions Incomplete/Unclear |
| <input type="checkbox"/> Cuffs | <input type="checkbox"/> Contamination | <input type="checkbox"/> Maintenance |
| <input type="checkbox"/> Heat Treat | <input type="checkbox"/> Countersink | <input type="checkbox"/> Mislabeled |
| <input type="checkbox"/> Inspection Strip in Tube | <input type="checkbox"/> Cut Too Short | <input type="checkbox"/> Misread |
| <input type="checkbox"/> Ripples in Bend | <input type="checkbox"/> Drill Holes | <input type="checkbox"/> Offset |
| <input type="checkbox"/> Torque Waves in Extrusion | <input type="checkbox"/> Drawing | <input type="checkbox"/> Out of Calibration |
| <input type="checkbox"/> Turning Sequence | <input type="checkbox"/> Finish | <input type="checkbox"/> Out of Sequence |
| <input type="checkbox"/> Wave/Twist in Tube | <input type="checkbox"/> Folio | <input type="checkbox"/> Outside Dimensions |
| | | <input type="checkbox"/> Ovalized |
| | | <input type="checkbox"/> Over/Under tolerance |
| | | <input type="checkbox"/> Part Incorrect |
| | | <input type="checkbox"/> Part Lost/Missing |
| | | <input type="checkbox"/> Part Moved |
| | | <input type="checkbox"/> Positioned Wrong |
| | | <input type="checkbox"/> Power Loss/Surge |
| | | <input type="checkbox"/> Pressure/Forced |
| | | <input type="checkbox"/> Temperature/Cure |
| | | <input type="checkbox"/> Weld |
| | | <input type="checkbox"/> Wrong Stock Pulled |
| | | <input type="checkbox"/> Other |
| | | <u>Me-1 - operator error</u> |
| | | <u>Me-2 - Material</u> |

| | | | |
|------------------|---------------|---|------------------------|
| DESIGN # | DRAWN BY # | DART AEROSPACE LTD HAWKESBURY, ONTARIO, CANADA | |
| CHECKED # | APPROVED # | DRAWING NO. SR-D130-701-1 | REV. A SHEET 6 OF 9 |
| DATE 02.11.26 | | TITLE STRESS REPORT | SCALE NTS |

6.2 AFT BRACKET (D3177-043)

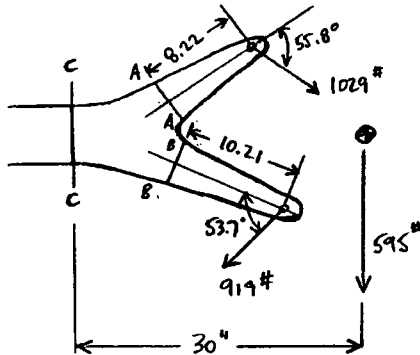

SECTION A-A

$$\text{FROM } F_z : M_{A-A} = (1029 \#)(1.5) \cos(90^\circ - 55.8^\circ)(8.22") \\ = 10494 \text{ in}\cdot\text{lb}$$

$$\text{FROM } F_x : M_{A-A} = (196 \#)(1.5) / 2 \times 8.22" = 1208 \text{ in}\cdot\text{lb}$$

SECTION B-B

$$\text{FROM } F_z : M_{B-B} = (919 \#)(1.5) \cos(90^\circ - 53.7^\circ)(10.21") \\ = 11343 \text{ in}\cdot\text{lb}$$

$$\text{FROM } F_x : M_{B-B} = (196 \#)(1.5) / 2 \times 10.21" = 1500 \text{ in}\cdot\text{lb}$$

SECTION C-C

AT THIS SECTION, D3177-041 IS WORST CASE AND THE MOMENTS WILL BE THE SAME.

6.3 MARGINS SUMMARY

| Part | Section | Direction | (M)max (in lb) | Fcy/Ftu (psi) | I (in ⁴) | <i>Actual</i> c (in) | (M)all (in lb) | MS |
|------------|---------|-----------|-------------------|------------------|-------------------------|----------------------------|-------------------|------|
| D3177-041 | A-A | z | 13791 | 34000 | 0.642 | 1.28 | 17053 | 0.24 |
| D3177-041 | A-A | x | 1419 | 34000 | 0.056 | 0.67 | 2842 | 1.00 |
| D3177-041 | B-B | z | 8497 | 34000 | 0.665 | 1.38 | 16384 | 0.93 |
| D3177-041 | B-B | x | 1357 | 34000 | 0.043 | 0.72 | 2031 | 0.50 |
| D3177-041 | C-C | z | 26775 | 34000 | 3.178 | 1.87 | 57782 | 1.16 |
| *D3177-041 | C-C | x | 5880 | 34000 | 0.145 | 0.60 | 8217 | 0.40 |
| *D3177-041 | C-C | x | 8820 | 38000 | 0.145 | 0.60 | 9183 | 0.04 |
| D3177-043 | A-A | z | 10494 | 34000 | 0.731 | 1.43 | 17380 | 0.66 |
| D3177-043 | A-A | x | 1208 | 34000 | 0.044 | 0.72 | 2078 | 0.72 |
| D3177-043 | B-B | z | 11343 | 34000 | 0.441 | 1.18 | 12761 | 0.12 |
| D3177-043 | B-B | x | 1500 | 34000 | 0.042 | 0.71 | 2020 | 0.35 |

* THE ABOVE TABLE SHOWS ULTIMATE LOADS TO YIELD PROPERTIES, EXCEPT FOR SECTION C-C, WHERE BOTH THE LIMIT & ULTIMATE CALCULATIONS HAVE BEEN DONE TO DEMONSTRATE POSITIVE MARGINS.

Copyright © 2002 by DART AEROSPACE LTD

THIS DOCUMENT IS PRIVATE AND CONFIDENTIAL AND IS SUPPLIED ON THE EXPRESS CONDITION THAT IT IS NOT TO BE USED FOR ANY PURPOSE OR COPIED OR COMMUNICATED TO ANY OTHER PERSON WITHOUT WRITTEN PERMISSION FROM DART AEROSPACE LTD.

7.1 Fastener Analysis

| Location | Load | Type | E | n | $1.15 \cdot 1.5 \cdot F/n$ | Fmax | MS |
|----------|--------------|-----------|------|---|----------------------------|-------|------|
| 1 | Double Shear | AN4 | 1029 | 1 | 1775 | 7360 | 3.15 |
| 2 | Double Shear | MS17984C5 | 2645 | 1 | 4563 | 14400 | 2.16 |
| 3 | Double Shear | AN5 | 2050 | 1 | 3536 | 11500 | 2.25 |
| 4 | Tensile | AN3 | 1758 | 4 | 758 | 3130 | 3.13 |
| 5 | Double Shear | MS17984C5 | 1758 | 1 | 3033 | 14400 | 3.75 |

7.2 Limit Bearing Analysis

| Location | Part | Material | E | n | $1.15 \cdot F/n$ | D | t | e/D | Fbrv | Fb | MS |
|----------|----------------|-----------------|------|---|------------------|-------|-------|------|-------|-------|------|
| 1 | D3172-041 | AISI 304/316 SS | 1029 | 2 | 592 | 0.250 | 0.063 | >2.0 | 55000 | 866 | 0.46 |
| → 1 | D3177-041/-043 | 6061-T6 | 1029 | 1 | 1183 | 0.250 | 0.694 | >2.0 | 60000 | 10410 | 7.80 |
| 2 | D3177-041/-043 | 6061-T6 | 2645 | 1 | 3042 | 0.313 | 0.970 | >2.0 | 60000 | 18217 | 4.99 |
| 2 | D3173-041 | 6061-T6 | 2645 | 2 | 1521 | 0.313 | 0.125 | >2.0 | 60000 | 2348 | 0.54 |
| 3 | D3177-041/-043 | 6061-T6 | 2050 | 1 | 2358 | 0.313 | 0.970 | >2.0 | 60000 | 18217 | 6.73 |
| 3 | D3173-041 | 6061-T6 | 2050 | 2 | 1179 | 0.313 | 0.125 | >2.0 | 60000 | 2348 | 0.99 |
| 5 | D3175-041 | 6061-T6 | 1758 | 2 | 1011 | 0.313 | 0.125 | 1.24 | 39960 | 1563 | 0.55 |

7.3 Ultimate Bearing Analysis

| Location | Part | Material | E | n | $1.15 \cdot 1.5 \cdot F/n$ | D | t | e/D | Fbru | Fb | MS |
|----------|----------------|-----------------|------|---|----------------------------|-------|-------|------|--------|-------|------|
| 1 | D3172-041 | AISI 304/316 SS | 1029 | 2 | 888 | 0.250 | 0.063 | >2.0 | 162000 | 2552 | 1.87 |
| → 1 | D3177-041/-043 | 6061-T6 | 1029 | 1 | 1775 | 0.250 | 0.694 | >2.0 | 82000 | 14227 | 7.02 |
| 2 | D3177-041/-043 | 6061-T6 | 2645 | 1 | 4563 | 0.313 | 0.970 | >2.0 | 82000 | 24896 | 4.46 |
| 2 | D3173-041 | 6061-T6 | 2645 | 2 | 2281 | 0.313 | 0.125 | >2.0 | 82000 | 3208 | 0.41 |
| 3 | D3177-041/-043 | 6061-T6 | 2050 | 1 | 3536 | 0.313 | 0.970 | >2.0 | 82000 | 24896 | 6.04 |
| 3 | D3173-041 | 6061-T6 | 2050 | 2 | 1768 | 0.313 | 0.125 | >2.0 | 82000 | 3208 | 0.81 |
| 5 | D3175-041 | 6061-T6 | 1758 | 2 | 1516 | 0.313 | 0.125 | 1.24 | 47360 | 1853 | 0.22 |

7.4 Limit Shear Analysis

| Location | Part | Material | E | n | $1.15 \cdot F/n$ | e | t | Fsy | Fs | MS |
|----------|----------------|-----------------|------|---|------------------|-------|-------|-------|-------|-------|
| 1 | D3172-041 | AISI 304/316 SS | 1029 | 2 | 592 | 0.621 | 0.063 | 15753 | 1233 | 1.08 |
| → 1 | D3177-041/-043 | 6061-T6 | 1029 | 1 | 1183 | 0.561 | 0.694 | 23263 | 18114 | 14.31 |
| 5 | D3175-041 | 6061-T6 | 1758 | 2 | 1011 | 0.242 | 0.125 | 23263 | 1407 | 0.39 |

7.5 Ultimate Shear Analysis

| Location | Part | Material | E | n | $1.5 \cdot 1.15 \cdot F/n$ | e | t | Fsu | Fs | MS |
|----------|----------------|-----------------|------|---|----------------------------|-------|-------|-------|-------|-------|
| 1 | D3172-041 | AISI 304/316 SS | 1029 | 2 | 888 | 0.621 | 0.063 | 55000 | 4304 | 3.85 |
| → 1 | D3177-041/-043 | 6061-T6 | 1029 | 1 | 1775 | 0.561 | 0.694 | 26000 | 20245 | 10.41 |
| 5 | D3175-041 | 6061-T6 | 1758 | 2 | 1516 | 0.242 | 0.125 | 26000 | 1573 | 0.04 |

MARGINS are positive with lug thickness
of 0.694. ∴ Acceptable 9/24/21